TWP. 13N. RGE. 2W. W.M.

LAND LINES ARE APPROXIMATE

RIGHT OF WAY MAP LEGEND

- EXISTING ROW
- REQUIRED ROW
- RIGHT OF WAY CENTERLINE
- EXISTING FENCE
- RAIL ROAD RIGHT OF WAY
- SECTION LINE
- QUARTER LINE
- SIXTEENTH LINE
- PROPERTY LINE
- RIGHT OF WAY ACQUISITION
- CUT/FILL AREAS
- OWNERSHIP TIE
- P.C. POINT OF CURVATURE
- P.I. POINT OF INTERSECTION
- P.T. POINT OF TANGENT
- SECTION CORNER
- QUARTER CORNER

Scale: 1" = 200'

RIGHT OF WAY WIDTHS

STA LEFT		STA RIGHT	
STA RANGE	WIDTH LT	STA RANGE	WIDTH RT
0+00- 1+00	30' LT	0+00- 1+00	30' RT
1+00 - 2+50	40' LT	1+00 - 2+50	40' RT
2+50 - 25+67	30' LT	2+50 - 32+00	30' RT
25+67 - 28+48.64	40' LT		
28+48.64 - 33+63.4 PC	35' LT	32+00 - 33+63.4 PC	35' RT
33+63.4 PC - 89+50	30' LT	33+63.4 PC - 41+50	30' RT
		41+50 - 51+00	35' RT
		51+00 - 89+50	30' RT
89+50 - 92+50	35' LT	89+50 - 92+50	45' RT
92+50 - 101+50	40' LT	92+50 - 99+00	80' RT
101+50 - 103+00	80' LT	99+00 - 103+00	30' RT
103+00 - 107+00	30' LT	103+00 - 107+00	50' RT
107+00 - 112+45.04 INT ROGERS RD ROW	70' LT	107+00 - 129+19.12 (BEG HWY 603 INT REALIGNMENT)	30' RT
(INT ROGERS RD ROW) 113+09.76 - 133+00 / HWY 603 ROW	30' LT	129+19.12 (CONT'S ALONG CURVE NOT PARALLEL TO ALIGNMENT CL)	34.14' RT
		130+00	38.34' RT
		131+00	53.49' RT
		132+00	80.20' RT
		132+11.29 (END OF CURVE)	89.99' RT
		132+30.48 (END SHOREY ROW AT HWY 603 ROW)	113.78' RT

T13N R2W A-05
3 1/2" LC ALUM CAP
PER HILLBURGER
PROJECT

S54°02'06"E
2339.87'

FB 895 PG 106 FOUND
BOAT SPIKE 0.4' BELOW
SURFACE, HELD FOR
0+00

T13N R2W A-03 SEPT 2015
FOUND 3 1/2" LC ALUM
CAP PER AFN 3289423

T13N R2W C-05
SET 3 1/2" LC ALUM CAP
2-2016 LCR AFN 3444455

T13N R2W C-03
SET 3 1/2" LC ALUM CAP
2-2016 LCR AFN 3444454

S88°59'53"E
404.30' FROM
PC

S00°27'17"E
416.75'

PC: 59+36.90

L=649.40, R=409.30
Δ=090.906

PT: 65+86.30

S 02°02'31" W 1382.00'

L=99.70, R=1146.00
Δ=004.985

PC: 4+25.10
PT: 5+24.80
PC: 6+10.90

S 33°17'48" W 86.10'

L=232.10, R=1432.50
Δ=009.283

PT: 8+43.00

S 42°34'48" W 262.30'

L=334.30, R=477.50
Δ=040.113

PT: 14+59.60
PC: 11+06.30

S 02°28'01" W 419.40'

PI: 18+50.00

15-40.6 LSP^21^SPE
27.26' TO N14.56'

0+00

19+21.72

S 01°10'01" W 642.60'

PI: 25+01.60

S 01°29'01" W 861.80'

L=301.40, R=358.10
Δ=048.224

PC: 33+63.40
PT: 36+64.80

PC: 33+10.10

L=228.60, R=204.64
Δ=064.004

34+00
PT: 35+38.70
PC: 35+92.90

S 65°28'16" W 54.20'

S 21°37'54" E 309.70'

PI: 42+13.70

N52°33'32"E
167.02'

L=311.10, R=204.64
Δ=087.103

S 14°02'59" E 167.30'

DEVEREESE RD
PER CHANGE IN PART OF
THOMAS DEVEREESE RD FB 630

S 86°34'09" W 847.44'

PI: 8+47.44
PI: 9+23.34

N 80°55'51" W 75.90'

S 78°44'09" W 472.56'

L=300.80, R=409.30
Δ=042.107

PT: 45+85.00

PC: 42+84.20

S 45°45'25" E 619.40'

S 89°51'51" E 1351.80'

SITE MP 1.431 (NORTH)
SITE MP 1.480 (WEST)
SITE MP 1.529 (EAST)
SITE MP 1.562 (EAST)
SITE MP 1.322 (NORTH)
SITE MP 1.381 (SOUTH)
SITE MP 1.328 (SOUTH)
SITE MP 1.770 (WEST)
SITE MP 1.788 (WEST)
SITE MP 0.338 (EAST)
SITE MP 0.351 (WEST)
SITE MP 0.434 (EAST)
SITE MP 0.448 (WEST)
SITE MP 0.552 (EAST)
SITE MP 0.582 (WEST)
SITE MP 0.651 (EAST)
SITE MP 0.673 (WEST)
SITE MP 0.708 (WEST)
SITE MP 0.732 (EAST)
SITE MP 0.818 (EAST)
SITE MP 0.818 (WEST)
SITE MP 0.869 (WEST)
SITE MP 0.966 (WEST)

S31 SE 1/4 OF SE 1/4
S31 GOVT LOT 7
S31 GOVT LOT 8
S31 GOVT LOT 9
S6 NE 1/4 OF NE 1/4
S6 SE 1/4 OF NE 1/4
S6 NW 1/4 OF NE 1/4
S6 SW 1/4 OF NE 1/4
S6 NW 1/4 OF SE 1/4
S6 NE 1/4 OF SE 1/4
S6 NE 1/4 OF NW 1/4
S6 SE 1/4 OF NW 1/4
S5 NW 1/4 OF SW 1/4

NPRR ROW
TUNE RD
SHOREY RD PER CRP 283
DEVEREESE RD
MATCH LINE 73+00
SOUTH LINE BOUNDED BY NEWAUKUM RIVER, NOT LOCATED BY THIS SURVEY
WAS STATE HWY 6 FORMERLY PRIMARY STATE HWY 3
CONCRETE MONUMENTS FOUND AT INTERSECTIONS

ELEVATIONS ARE BASED ON NAVD '88 FROM RTK OBSERVATIONS.

BEARINGS ARE BASED ON NAD 83/91 (WASHINGTON STATE PLANE GRID, SOUTH ZONE) HORIZONTAL CONTROL FOR PROJECT WAS DERIVED FROM RTK METHOD.

HWY 603 1000 WAS USED AS THE BASE POINT.

CALIBRATION POINTS WSDOT: VALDEZ, CHE 19, P 532, GP 30, GP 31, AP STA A, AND LC STATIC PT: HWY 603 1000.

SHOREY ROAD RIGHT OF WAY

-1889 DEVEREESE RD DECLARED A PUBLIC HIGHWAY IN AUG TERM OF 1889. PLATTED VOL 1 PG 944. SURVEY OF ROAD DETERMINES THE ROAD SHOULD BE 60' IN WIDTH.

-1901 ORDER OF ESTABLISHMENT SHOREY RD #378 ESTABLISHED AT 30' WIDE. SEE SHOREY RD FILE #1267. (ALIGNMENT FB 7) AT THAT TIME THE ROAD RAN FROM 9.3 CH NORTH OF THE CENTER 1/4 OF SECTION 6 AND RAN SOUTHERLY TO THE NEWAUKUM/BOISTFORT RD (HWY 603). HELD EAST 1/4 CORNER SECTION 6 T13N R2W AND ROTATED TO THE SE CORNER SECTION 6 T13N R2W.

-1927 ALIGNMENT: HELD FOUND SPIKE FOR 0+00 AND ROTATED TO EAST 1/4 CORNER SECTION 6 T13N R2W.

-1951 SHOREY RD WAS IMPROVED AND REALIGNED CRP 283 (THIS ALIGNMENT WAS USED FOR RIGHT OF WAY CENTERLINE), BUT STILL CLOSELY FOLLOWED THE 1901 PORTIOIN OF THE ALIGNMENT. VARYING WIDTHS OF ADDITIONAL RIGHT OF WAY WERE ACQUIRED IN MULTIPLE LOCATIONS. FOR THIS ALIGNMENT THE FOUND SPIKE FOR 0+00 WAS HELD AND THE ALIGNMENT WAS ROTATED TO THE WEST 1/4 CORNER SECTION 8 T13N R2W.

AS OF YET NO FORMAL VACATION OF THE 1901 RIGHT OF WAY HAS BEEN LOCATED IN THE ROAD FILES. FOR THE MOST PART THE 1951 REALIGNMENT FOLLOWS AND ADDITIONAL RIGHT OF WAY ACQUISITION COVERS OR APPEARS TO HAVE ACQUIRED RIGHT OF WAY BEYOND THE 1901 RIGHT OF WAY WITH SOME EXCEPTIONS WHERE THE 1951 ALIGNMENT SIGNIFICANTLY DEVIATES FROM THE 1901 ALIGNMENT. THIS OCCURRED BETWEEN (1951) STATIONS 79+68.30 TO 108+00 IN 3 PLACES AT ANGLE POINTS IN THE 1901 ALIGNMENT.

-TUNE ROAD ALIGNMENT FB 50 PG 21. HELD NORTH 1/4 CORNER SECTION 6 T13N R2W AND ROTATED STA 36+89.4 ANGLE PT "5" TO AN INTERSECTION OF THE EAST LINE OF LEVI GATES DLC #44 AND A 65' OFFSET OF AS BUILT U.P. RAILWAY.

-DEVEREESE ROAD ALIGNEMENT FB 630 AND TRACING FILE 17719 "CHANGE PART OF THOMAS DEVEREESE ROAD" WAS ENTERED PER FB NOTES BASED ON THE 1951 SHOREY RD ALIGNMENT.

VICINITY MAP

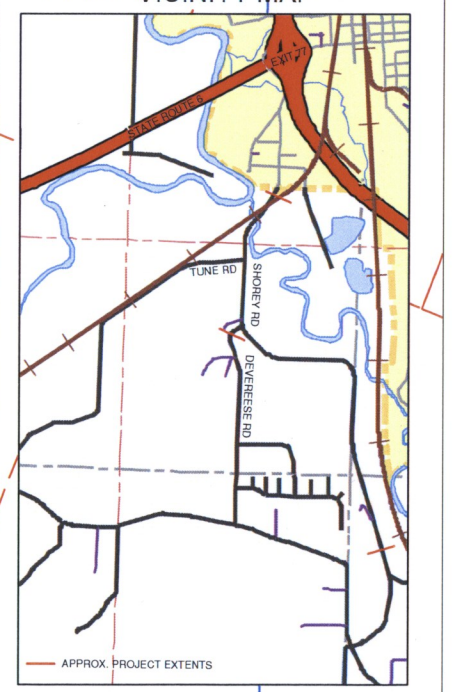

Lewis County
Department of Public Works

2025 NE KRESKY AVE.
CHEHALIS WA 98532
PHONE # (360) 740-1123
FAX # (360) 740-2719

DESIGNED BY :
DRAWN BY : TS
CHECKED BY :
DATE : 6-30-16

RIGHT OF WAY ALIGNMENT APPROVED BY :

SURVEY :	DATE :
PROPERTY MANAGEMENT :	DATE :
ASSISTANT COUNTY ENGINEER:	DATE :

NO.	DATE	REVISION	BY	APP.

SHOREY RD.
LEWIS COUNTY SAFETY
PROGRAM PHASE 2

COUNTY ROAD PROJECT NO: 2174B
RAP PROJECT NO: ???????
FEDERAL-AID NO: ????????

RIGHT OF WAY MAP
STA 0+00 TO STA 75+00

SHEET 1 OF 10

CALL 48 HOURS BEFORE YOU DIG
1-800-424-5555
"It's the Law"
Utilities Underground Location Center

Martin P. Roy, P.L.S.
Senior Engineer
Land Development Liaison

Date: _____

MARTIN P. ROY
STATE OF WASHINGTON
35901
REGISTERED
PROFESSIONAL LAND SURVEYOR

TWP. 12N. RGE. 3W. W.M.

LAND LINES ARE APPROXIMATE

RIGHT OF WAY WIDTHS			
STA LEFT		STA RIGHT	
STA RANGE	WIDTH LT	STA RANGE	WIDTH RT
0+00- 1+00	30' LT	0+00- 1+00	30' RT
1+00 - 2+50	40' LT	1+00 - 2+50	40' RT
2+50 - 25+67	30' LT	2+50 - 32+00	30' RT
25+67 - 28+48.64	40' LT		
28+48.64 - 33+63.4 PC	35' LT	32+00 - 33+63.4 PC	35' RT
33+63.4 PC - 89+50	30' LT	33+63.4 PC - 41+50	30' RT
		41+50 - 51+00	35' RT
		51+00 - 89+50	30' RT
89+50 - 92+50	35' LT	89+50 - 92+50	45' RT
92+50 - 101+50	40' LT	92+50 - 99+00	80' RT
101+50 - 103+00	80' LT	99+00 - 103+00	30' RT
103+00 - 107+00	30' LT	103+00 - 107+00	50' RT
107+00 - 112+45.04 INT ROGERS RD ROW	70' LT	107+00 - 129+19.12 (BEG HWY 603 INT REALIGNMENT)	30' RT
(INT ROGERS RD ROW) 113+09.76 - 133+00 / HWY 603 ROW	30' LT	129+19.12 (CONT'S ALONG CURVE NOT PARALLEL TO ALIGNMENT CL)	34.14' RT
		130+00	38.34' RT
		131+00	53.49' RT
		132+00	80.20' RT
		132+11.29 (END OF CURVE)	89.99' RT
		132+30.48 (END SHOREY ROW AT HWY 603 ROW)	113.78' RT

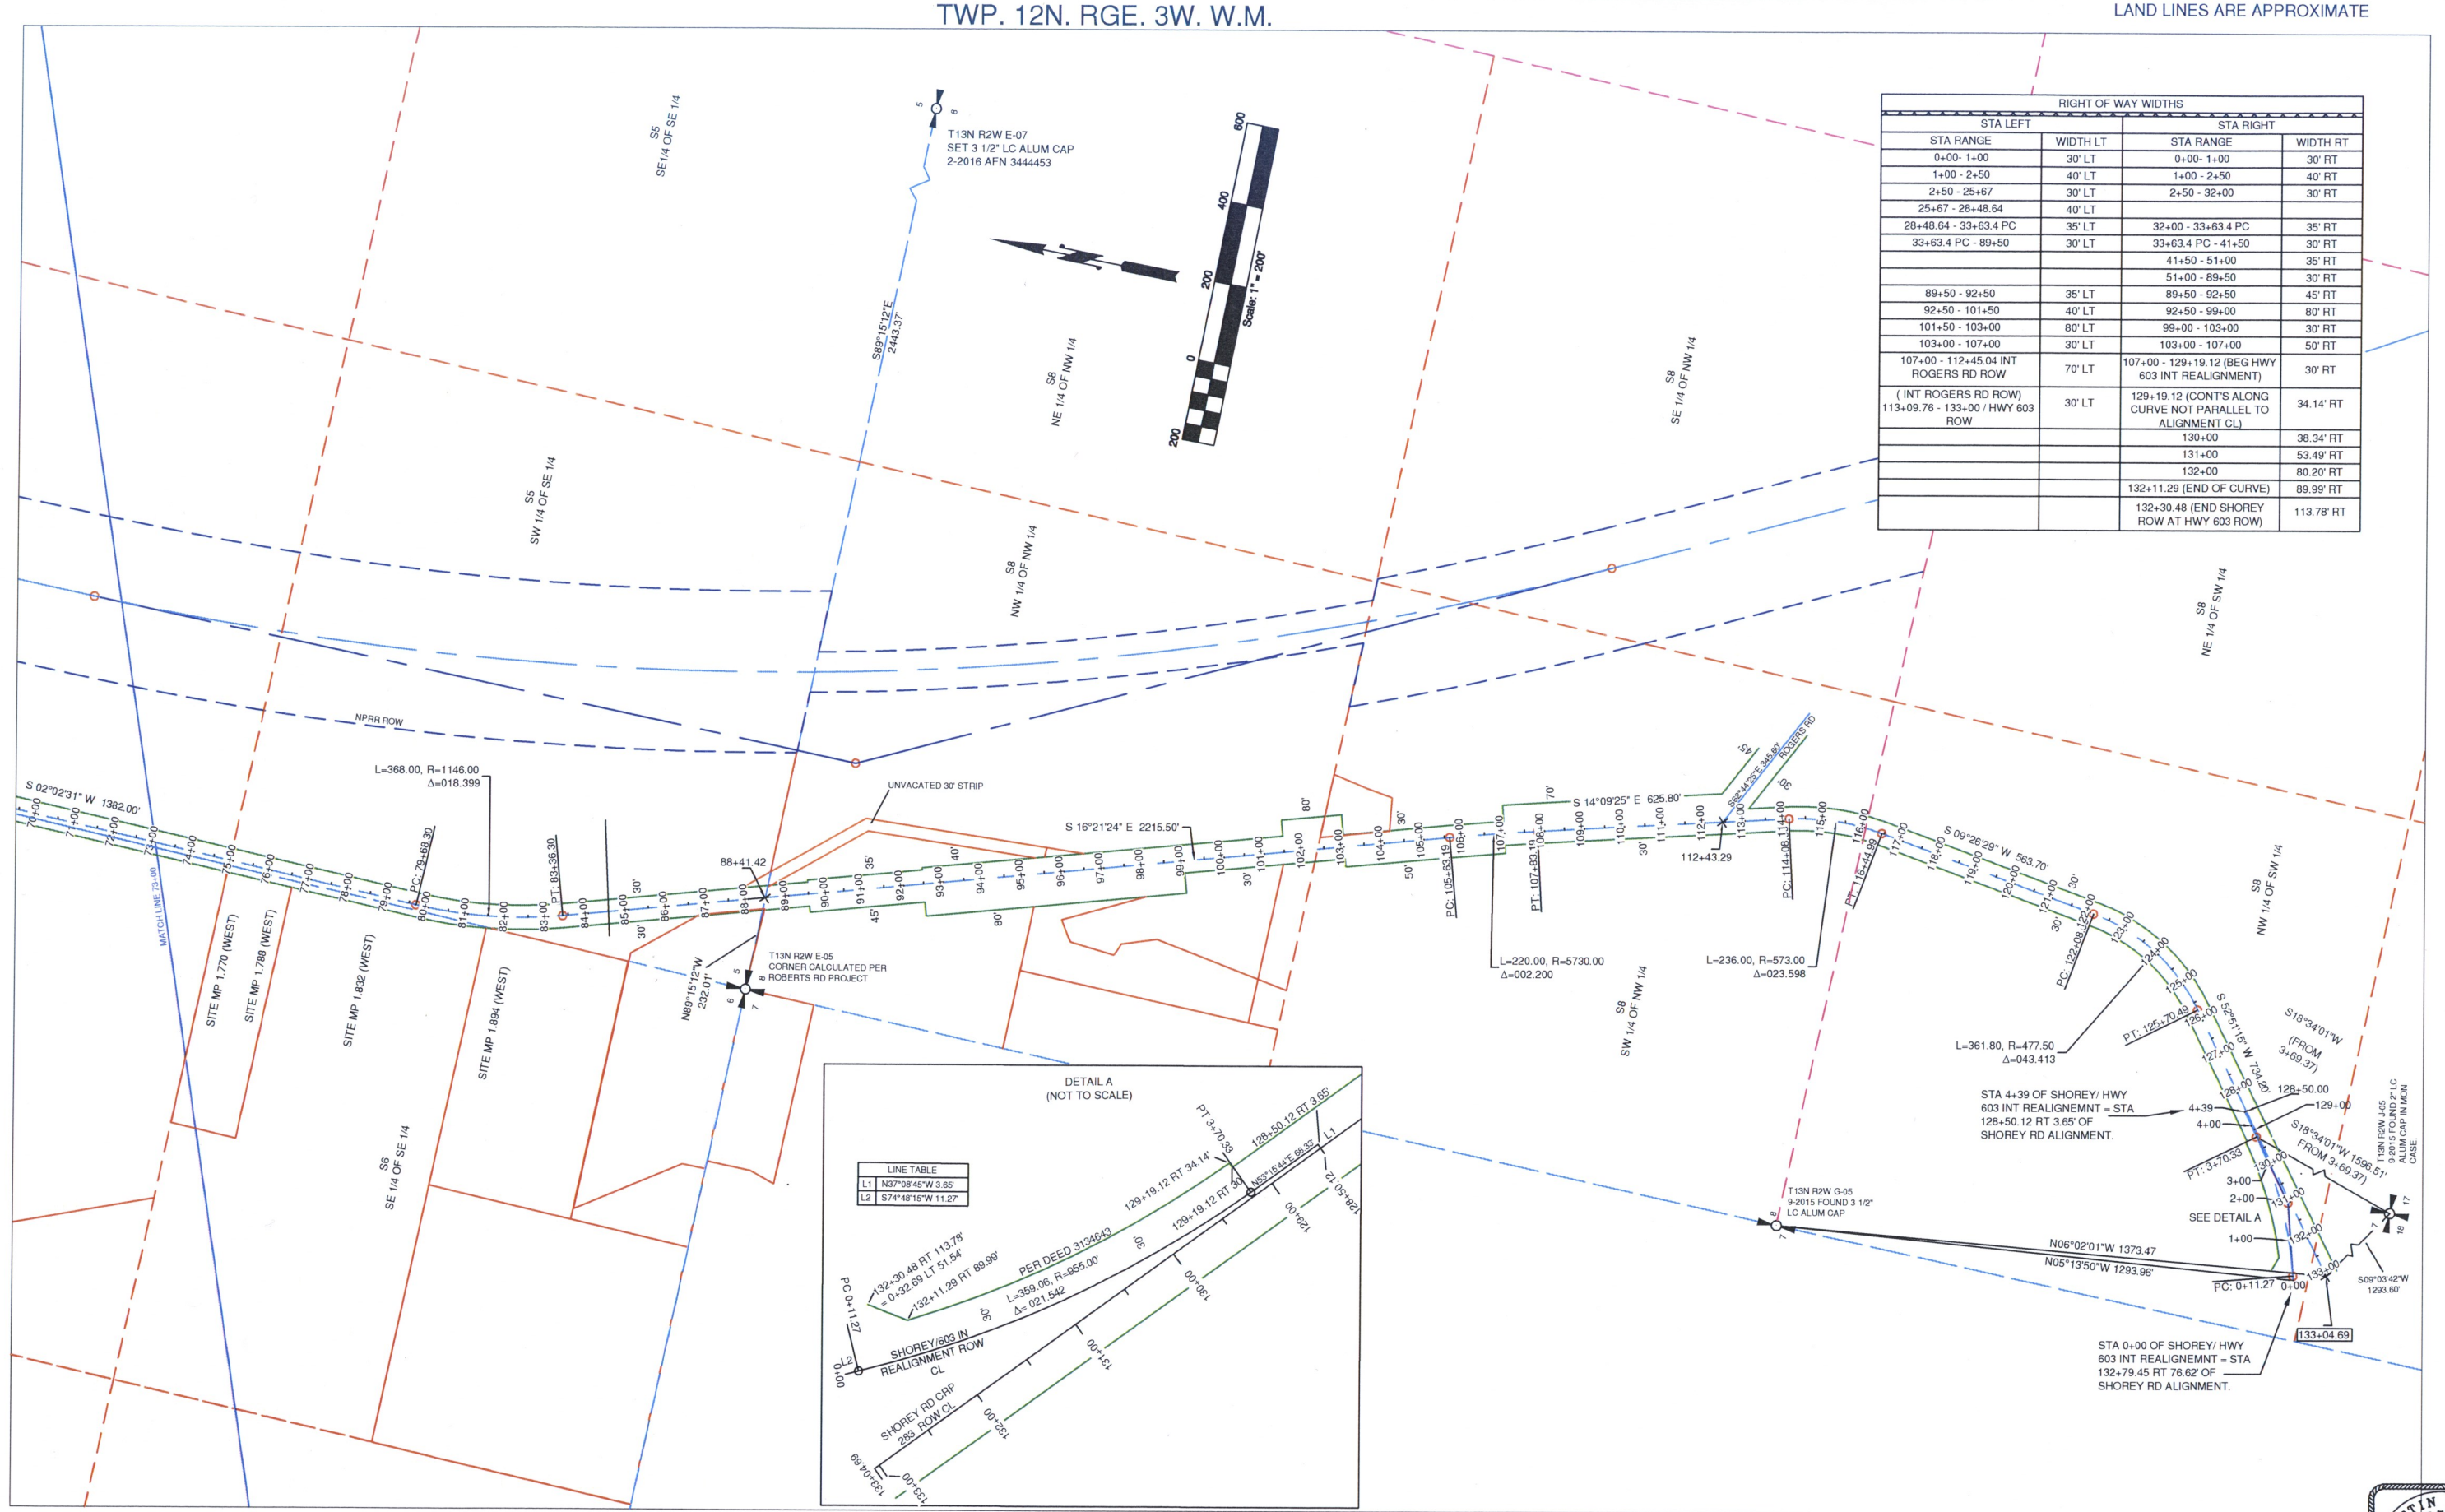

Lewis County Department of Public Works	2025 NE KRESKY AVE. CHEHALIS WA 98532 PHONE # (360) 740-1123 FAX # (360) 740-2719	DESIGNED BY : DRAWN BY : TS CHECKED BY : DATE : 6-30-16	RIGHT OF WAY ALIGNMENT APPROVED BY : SURVEY : DATE : PROPERTY MANAGEMENT : DATE : ASSISTANT COUNTY ENGINEER: DATE :	NO.	DATE	REVISION	BY / APP.
SHOREY RD. LEWIS COUNTY SAFETY PROGRAM PHASE 2	COUNTY ROAD PROJECT NO: 2174B RAP PROJECT NO: ??????? FEDERAL-AID NO: ????????? RIGHT OF WAY MAP STA 75+00 TO STA 133+04.69	SHEET 2 OF 10	CALL 48 HOURS BEFORE YOU DIG 1-800-424-5555 "It's the Law" Utilities Underground Location Center	Martin P. Roy, P.L.S. Senior Engineer Land Development Liaison Date:	MARTIN P. ROY STATE OF WASHINGTON 35981 REGISTERED PROFESSIONAL LAND SURVEYOR		

S31 TWP. 13N. RGE. 2W. W.M.

LAND LINES ARE APPROXIMATE

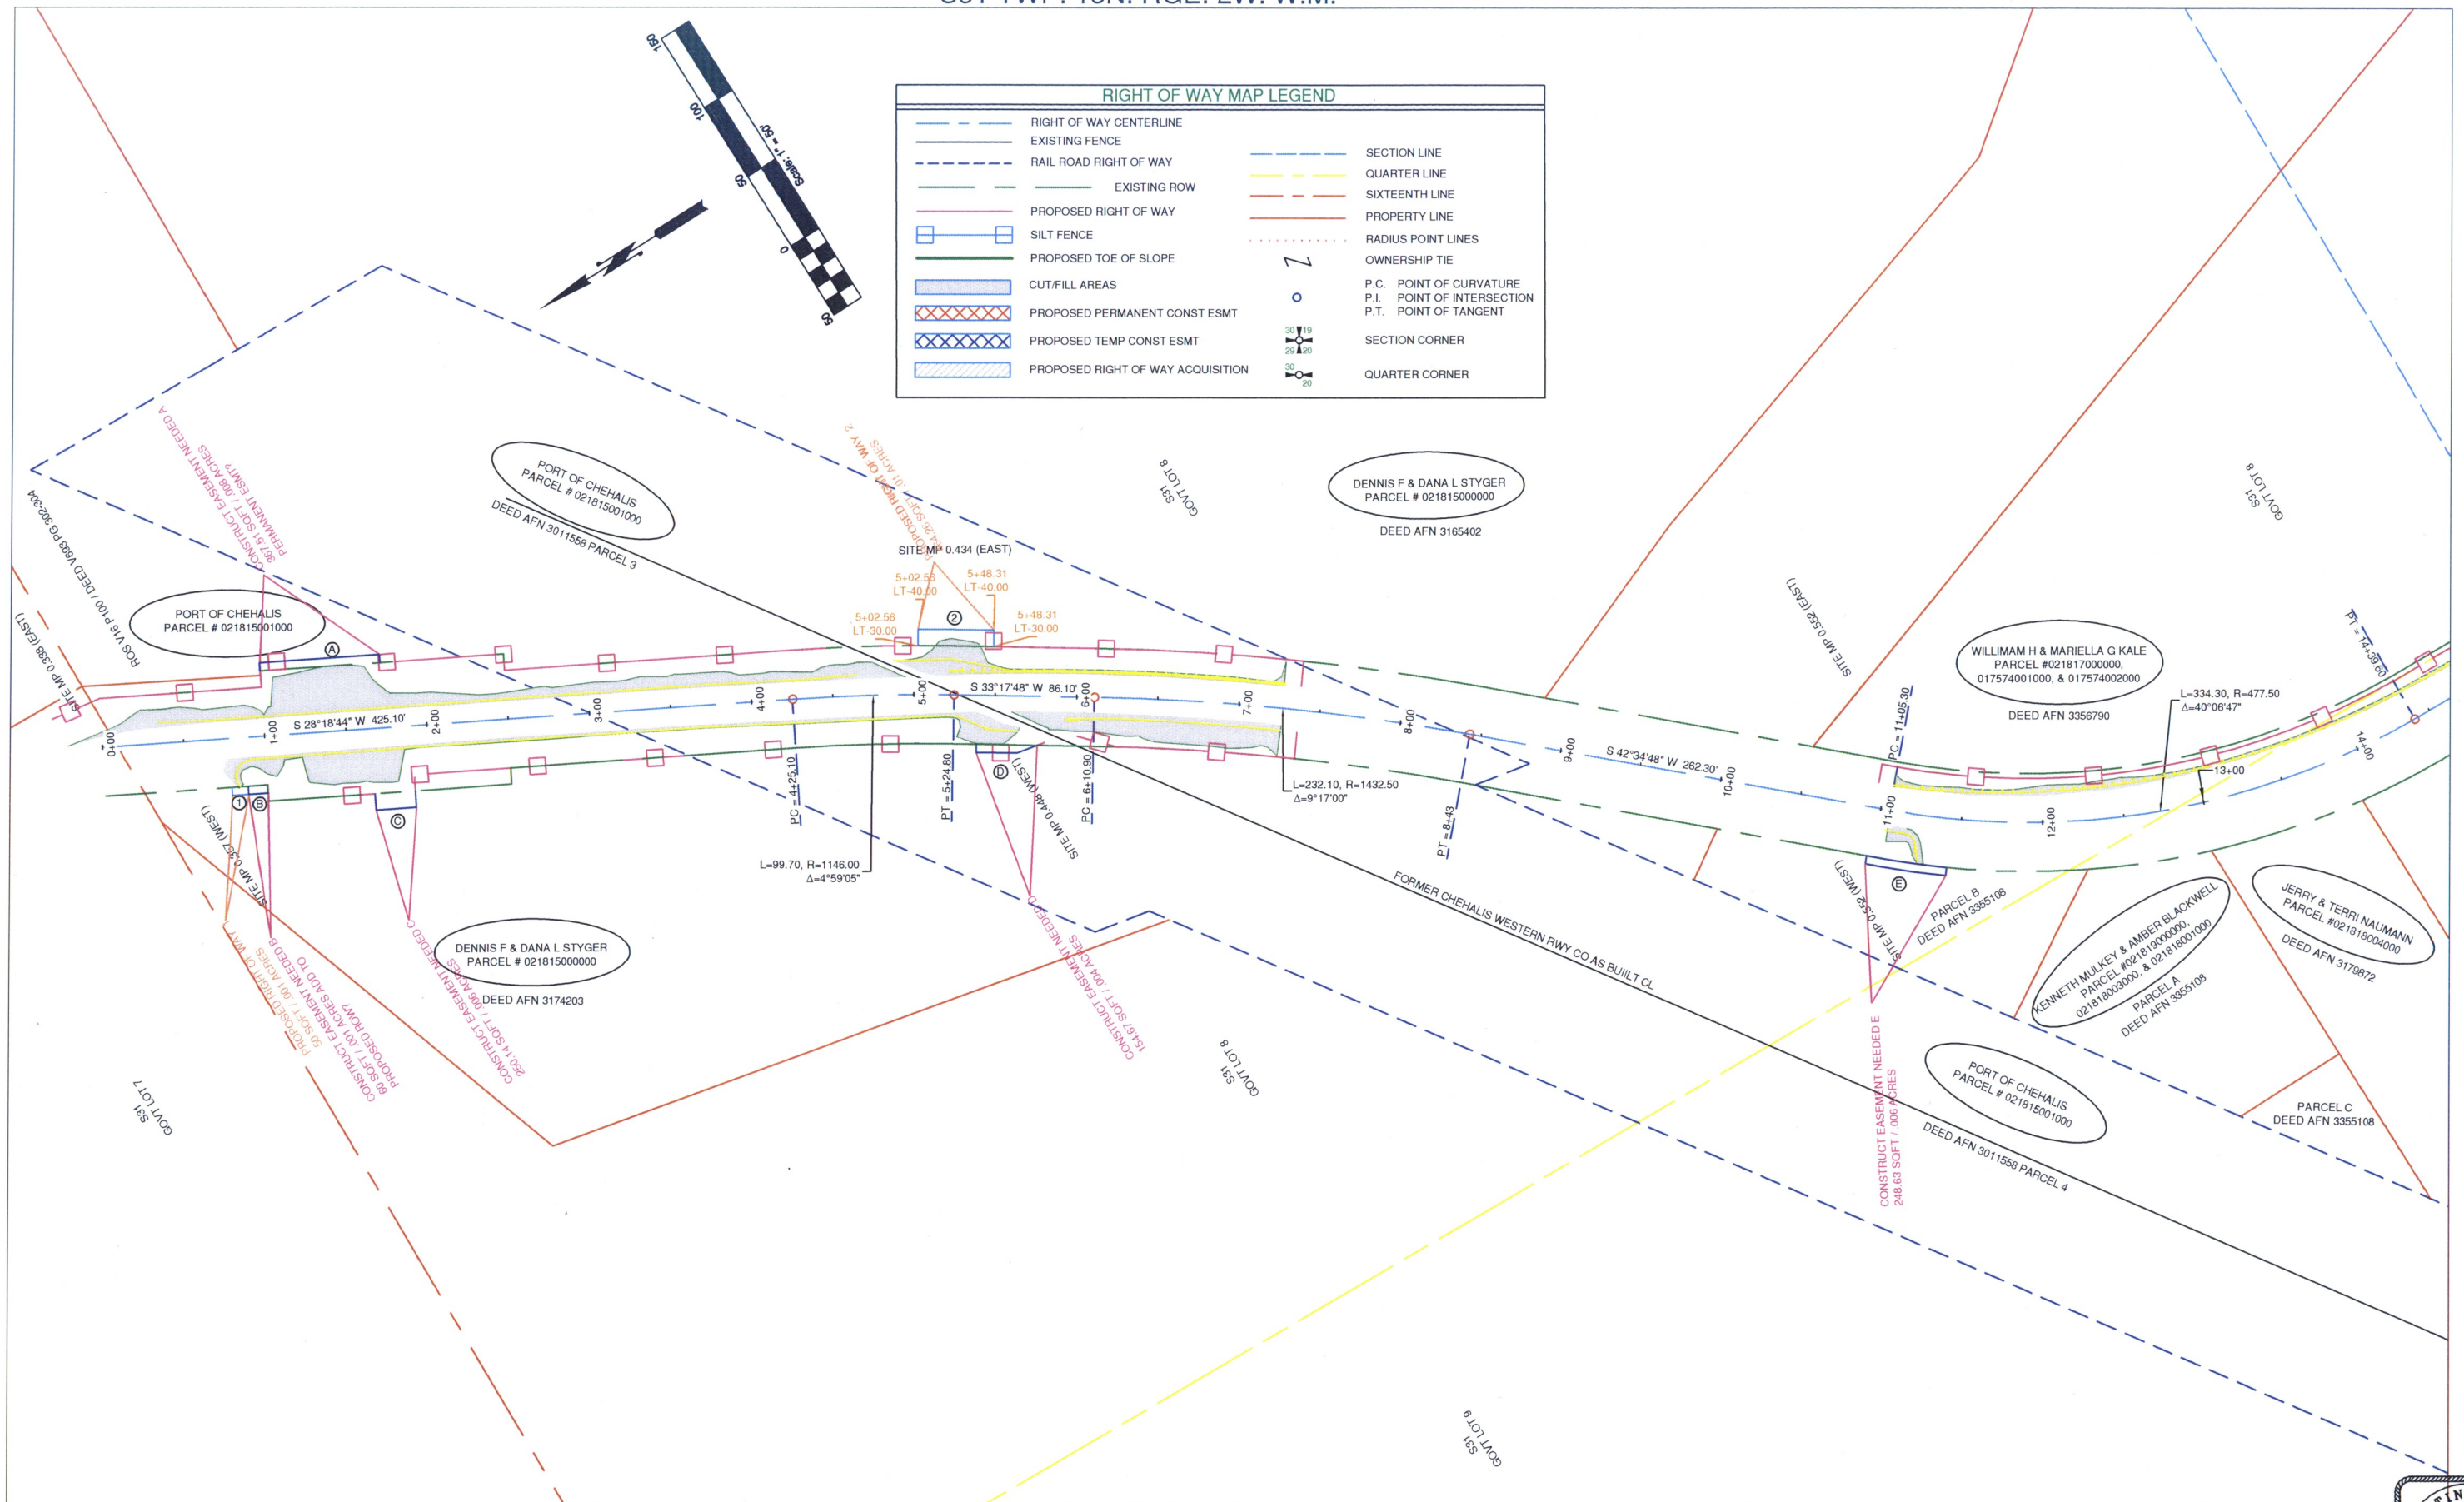

Lewis County Department of Public Works	2025 NE KRESKY AVE. CHEHALIS WA 98532 PHONE # (360) 740-1123 FAX # (360) 740-2719	DESIGNED BY : DRAWN BY : TS CHECKED BY : DATE : 6-24-16	RIGHT OF WAY ALIGNMENT APPROVED BY : SURVEY : DATE : PROPERTY MANAGEMENT : DATE : ASSISTANT COUNTY ENGINEER: DATE :	NO.	DATE	REVISION	BY	APP.	SHOREY RD. LEWIS COUNTY SAFETY PROGRAM PHASE 2	COUNTY ROAD PROJECT NO: 2174B RAP PROJECT NO: ??????? FEDERAL-AID NO: ???????? RIGHT OF WAY MAP STA 0+00 TO STA 14+00	SHEET 3 OF 10	CALL 48 HOURS BEFORE YOU DIG 1-800-424-5555 "It's the Law" Utilities Underground Location Center	Martin P. Roy, P.L.S. Senior Engineer Land Development Liaison Date: _____	MARTIN P. ROY STATE OF WASHINGTON 35081 REGISTERED PROFESSIONAL LAND SURVEYOR

S31 TWP. 14N. RGE. 2W. & S6 TWP. 13N RGE. 2W. W.M.

LAND LINES ARE APPROXIMATE

S31
GOVT LOT 8

WILLIMAM H & MARIELLA G KALE
PARCEL #021817000000,
017574001000, & 017574002000
DEED AFN 3356790

PROPOSED RIGHT OF WAY 3
308.93 SQFT / .007 ACRES

CONSTRUCT EASEMENT NEEDED F
776.01 SQFT / .02 ACRES
PERMANENT CONST ESMT?

SITE MP 0.651 (EAST)

T 13N R2W A-03 SEPT 2015
FOUND 3 1/2" LC ALUM CAP
PER AFN 3289423

PT = 14+39.60

D, R=477.50
47"

NW 1/4 OF THE NE 1/4 S6

SITE MP 0.732 (EAST)

CONSTRUCT EASEMENT NEEDED H
1783.99 SQFT / .04 ACRES

DONALD & GRETHE BURBEE
PARCEL # 017576000000

PROPOSED RIGHT OF WAY 5
1301.67 SQFT / .03 ACRES

SITE MP 0.818 (EAST)

DONALD & GRETHE BURBEE
PARCEL # 017575000000

S 02°28'01" W 419.40'

S 01°10'01" W 642.60'

14+00 15+00 16+00 17+00 18+00 19+00 20+00 21+00 22+00 23+00 24+00 25+00 26+00 27+00 28+00

0+00 19+21.72

18+84.01
RT30.00

19+09.09
RT30.00

0+23.08

0+49.96
RT40.00

0+71.65
RT93.00

PI = 18+59

PI = 25+01.60

1+00 2+00 3+00 4+00

SITE MP 0.673 (WEST)

SITE MP 0.708 (WEST)

SITE MP 0.818 (WEST)

SITE MP 0.869 (WEST)

CONSTRUCT EASEMENT NEEDED G
100 SQFT / .002 ACRES

PROPOSED RIGHT OF WAY AND
OR CONSTRUCTION EASEMENT
4 2769.45 SQFT / .06 ACRES

2+01.00
RT33.00

2+01.00
RT15.00

S 85° 34' 09" W
924.36'

TUNE RD

NE 1/4 OF THE NW 1/4 S6

CONSTRUCT EASEMENT NEEDED I
1896.62 SQFT / .04 ACRES
PERMANENT ESMT?

CONSTRUCT EASEMENT NEEDED J
2482.71 SQFT / .06 ACRES
AND SMALL PERMANENT ESMT OR
RW PURCHASE AT N END?

KEITH R BIRCHARD
& CECILIA HAUER
PARCEL # 017585001004
ROS V23 PG 296

SHAWN D & SANDY J JONES
PARCEL # 017585001003
ROS V23 PG 296

WILLIMAM H & MARIELLA G KALE
PARCEL # 021818002000
DEED AFN 3356790

WILLIMAM H & MARIELLA G KALE
PARCEL # 017579000000
DEED AFN 3356790

JOSEPH A BALMELLI
PARCEL # 017594002000

GOVT LOT 9 S31

DEED AFN 3011558 PARCEL 4

Scale: 1" = 50'
150 100 50 0 50

Lewis County Department of Public Works 2025 NE KRESKY AVE. CHEHALIS WA 98532 PHONE # (360) 740-1123 FAX # (360) 740-2719	DESIGNED BY : DRAWN BY : TS CHECKED BY : DATE : 6-30-16	RIGHT OF WAY ALIGNMENT APPROVED BY : SURVEY : DATE : PROPERTY MANAGEMENT : DATE : ASSISTANT COUNTY ENGINEER: DATE :	NO.	DATE	REVISION	BY	APP.
SHOREY RD. LEWIS COUNTY SAFETY PROGRAM PHASE 2	COUNTY ROAD PROJECT NO: 2174B RAP PROJECT NO: ??????? FEDERAL-AID NO: ???????? SHOREY RD RIGHT OF WAY MAP STA 14+00 TO STA 28+00 TUNE RD STA 0+00 TO 2+03.8	SHEET 4 OF 10	CALL 48 HOURS BEFORE YOU DIG 1-800-424-5555 "It's the Law" Utilities Underground Location Center	Martin P. Roy, P.L.S. Senior Engineer Land Development Liaison Date:	MARTIN P. ROY STATE OF WASHINGTON 35061 REGISTERED PROFESSIONAL LAND SURVEYOR		

S6 TWP. 13N. RGE. 2W. W.M.

LAND LINES ARE APPROXIMATE

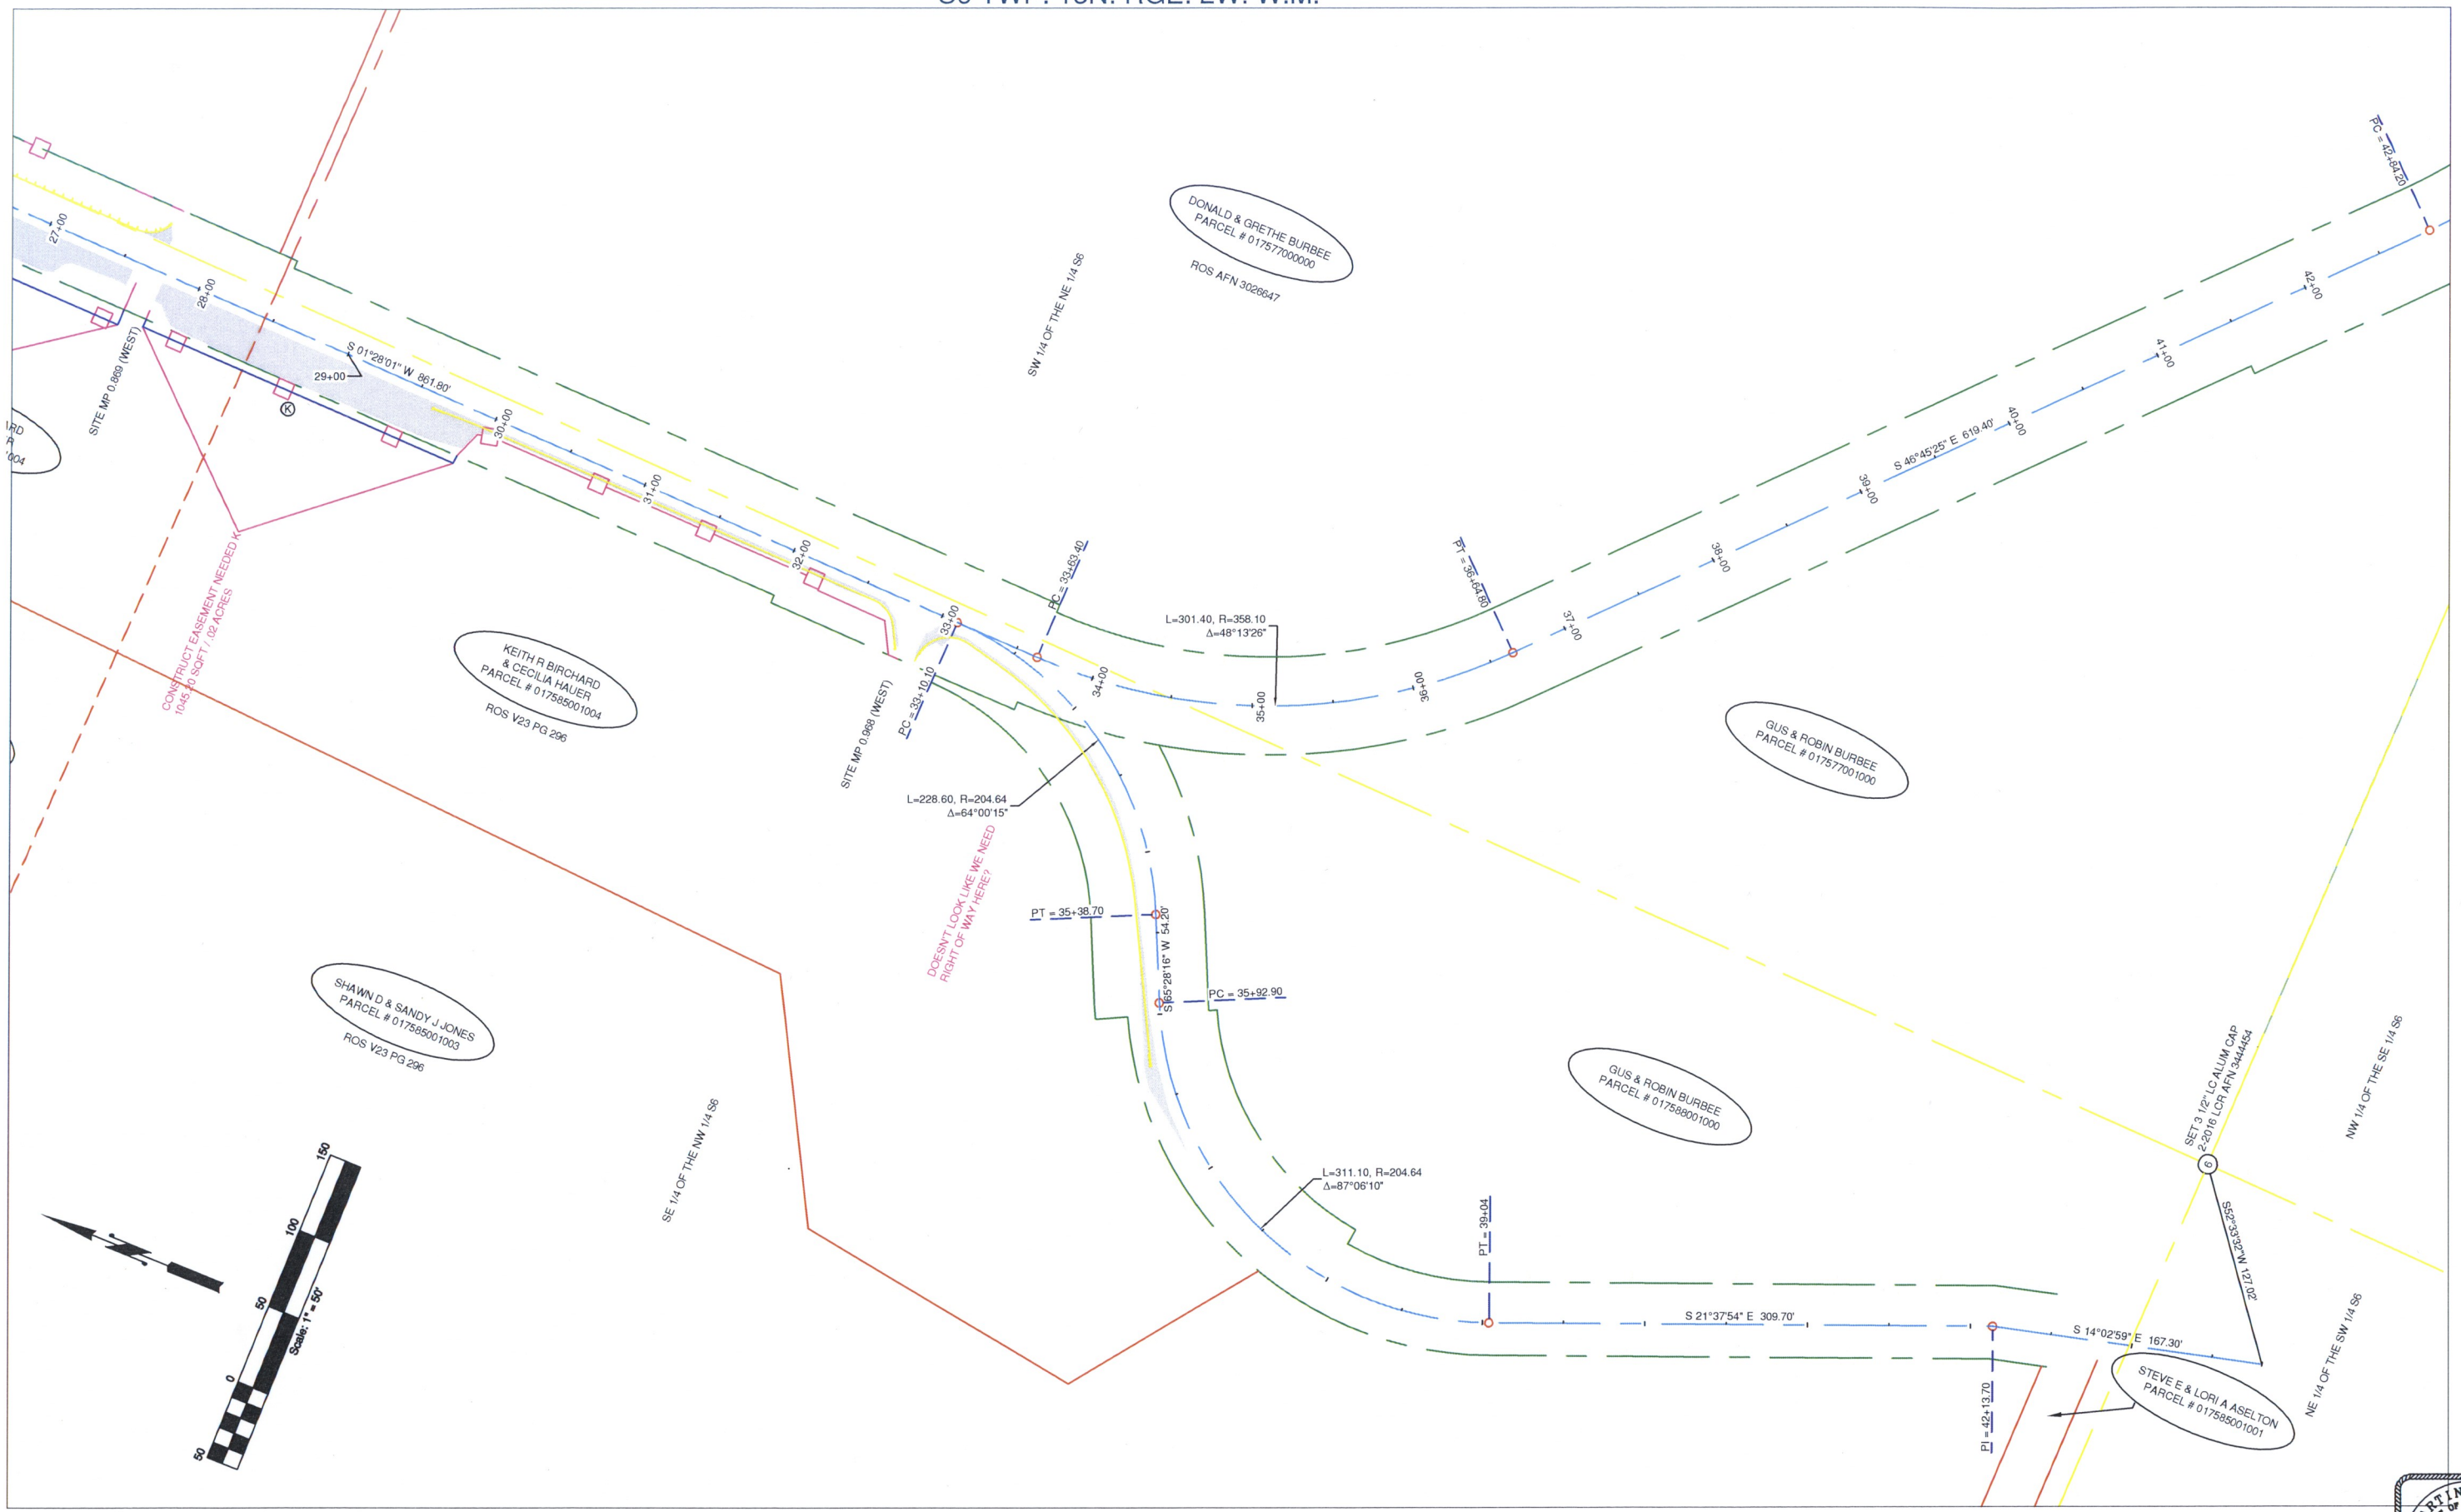

Lewis County Department of Public Works	2025 NE KRESKY AVE. CHEHALIS WA 98532 PHONE # (360) 740-1123 FAX # (360) 740-2719	DESIGNED BY : DRAWN BY : TS CHECKED BY : DATE : 6-30-16	RIGHT OF WAY ALIGNMENT APPROVED BY : SURVEY : DATE : PROPERTY MANAGEMENT : DATE : ASSISTANT COUNTY ENGINEER: DATE :	NO.	DATE	REVISION	BY	APP.

SHOREY RD.
LEWIS COUNTY SAFETY
PROGRAM PHASE 2

COUNTY ROAD PROJECT NO: 2174B
RAP PROJECT NO: ???????
FEDERAL-AID NO: ????????
RIGHT OF WAY MAP
STA 28+00 TO STA 42+00 (SHOREY)
STA 33+00 TO 42+13.70 (DEVEREESE)

SHEET 5 OF 10

CALL 48 HOURS BEFORE YOU DIG
1-800-424-5555
"It's the Law"
Utilities Underground Location Center

Martin P. Roy, P.L.S.
Senior Engineer
Land Development Liaison

Date: _____

MARTIN P. ROY
STATE OF WASHINGTON
35031
REGISTERED
PROFESSIONAL LAND SURVEYOR

S6 TWP. 13N. RGE. 2W. W.M.

LAND LINES ARE APPROXIMATE

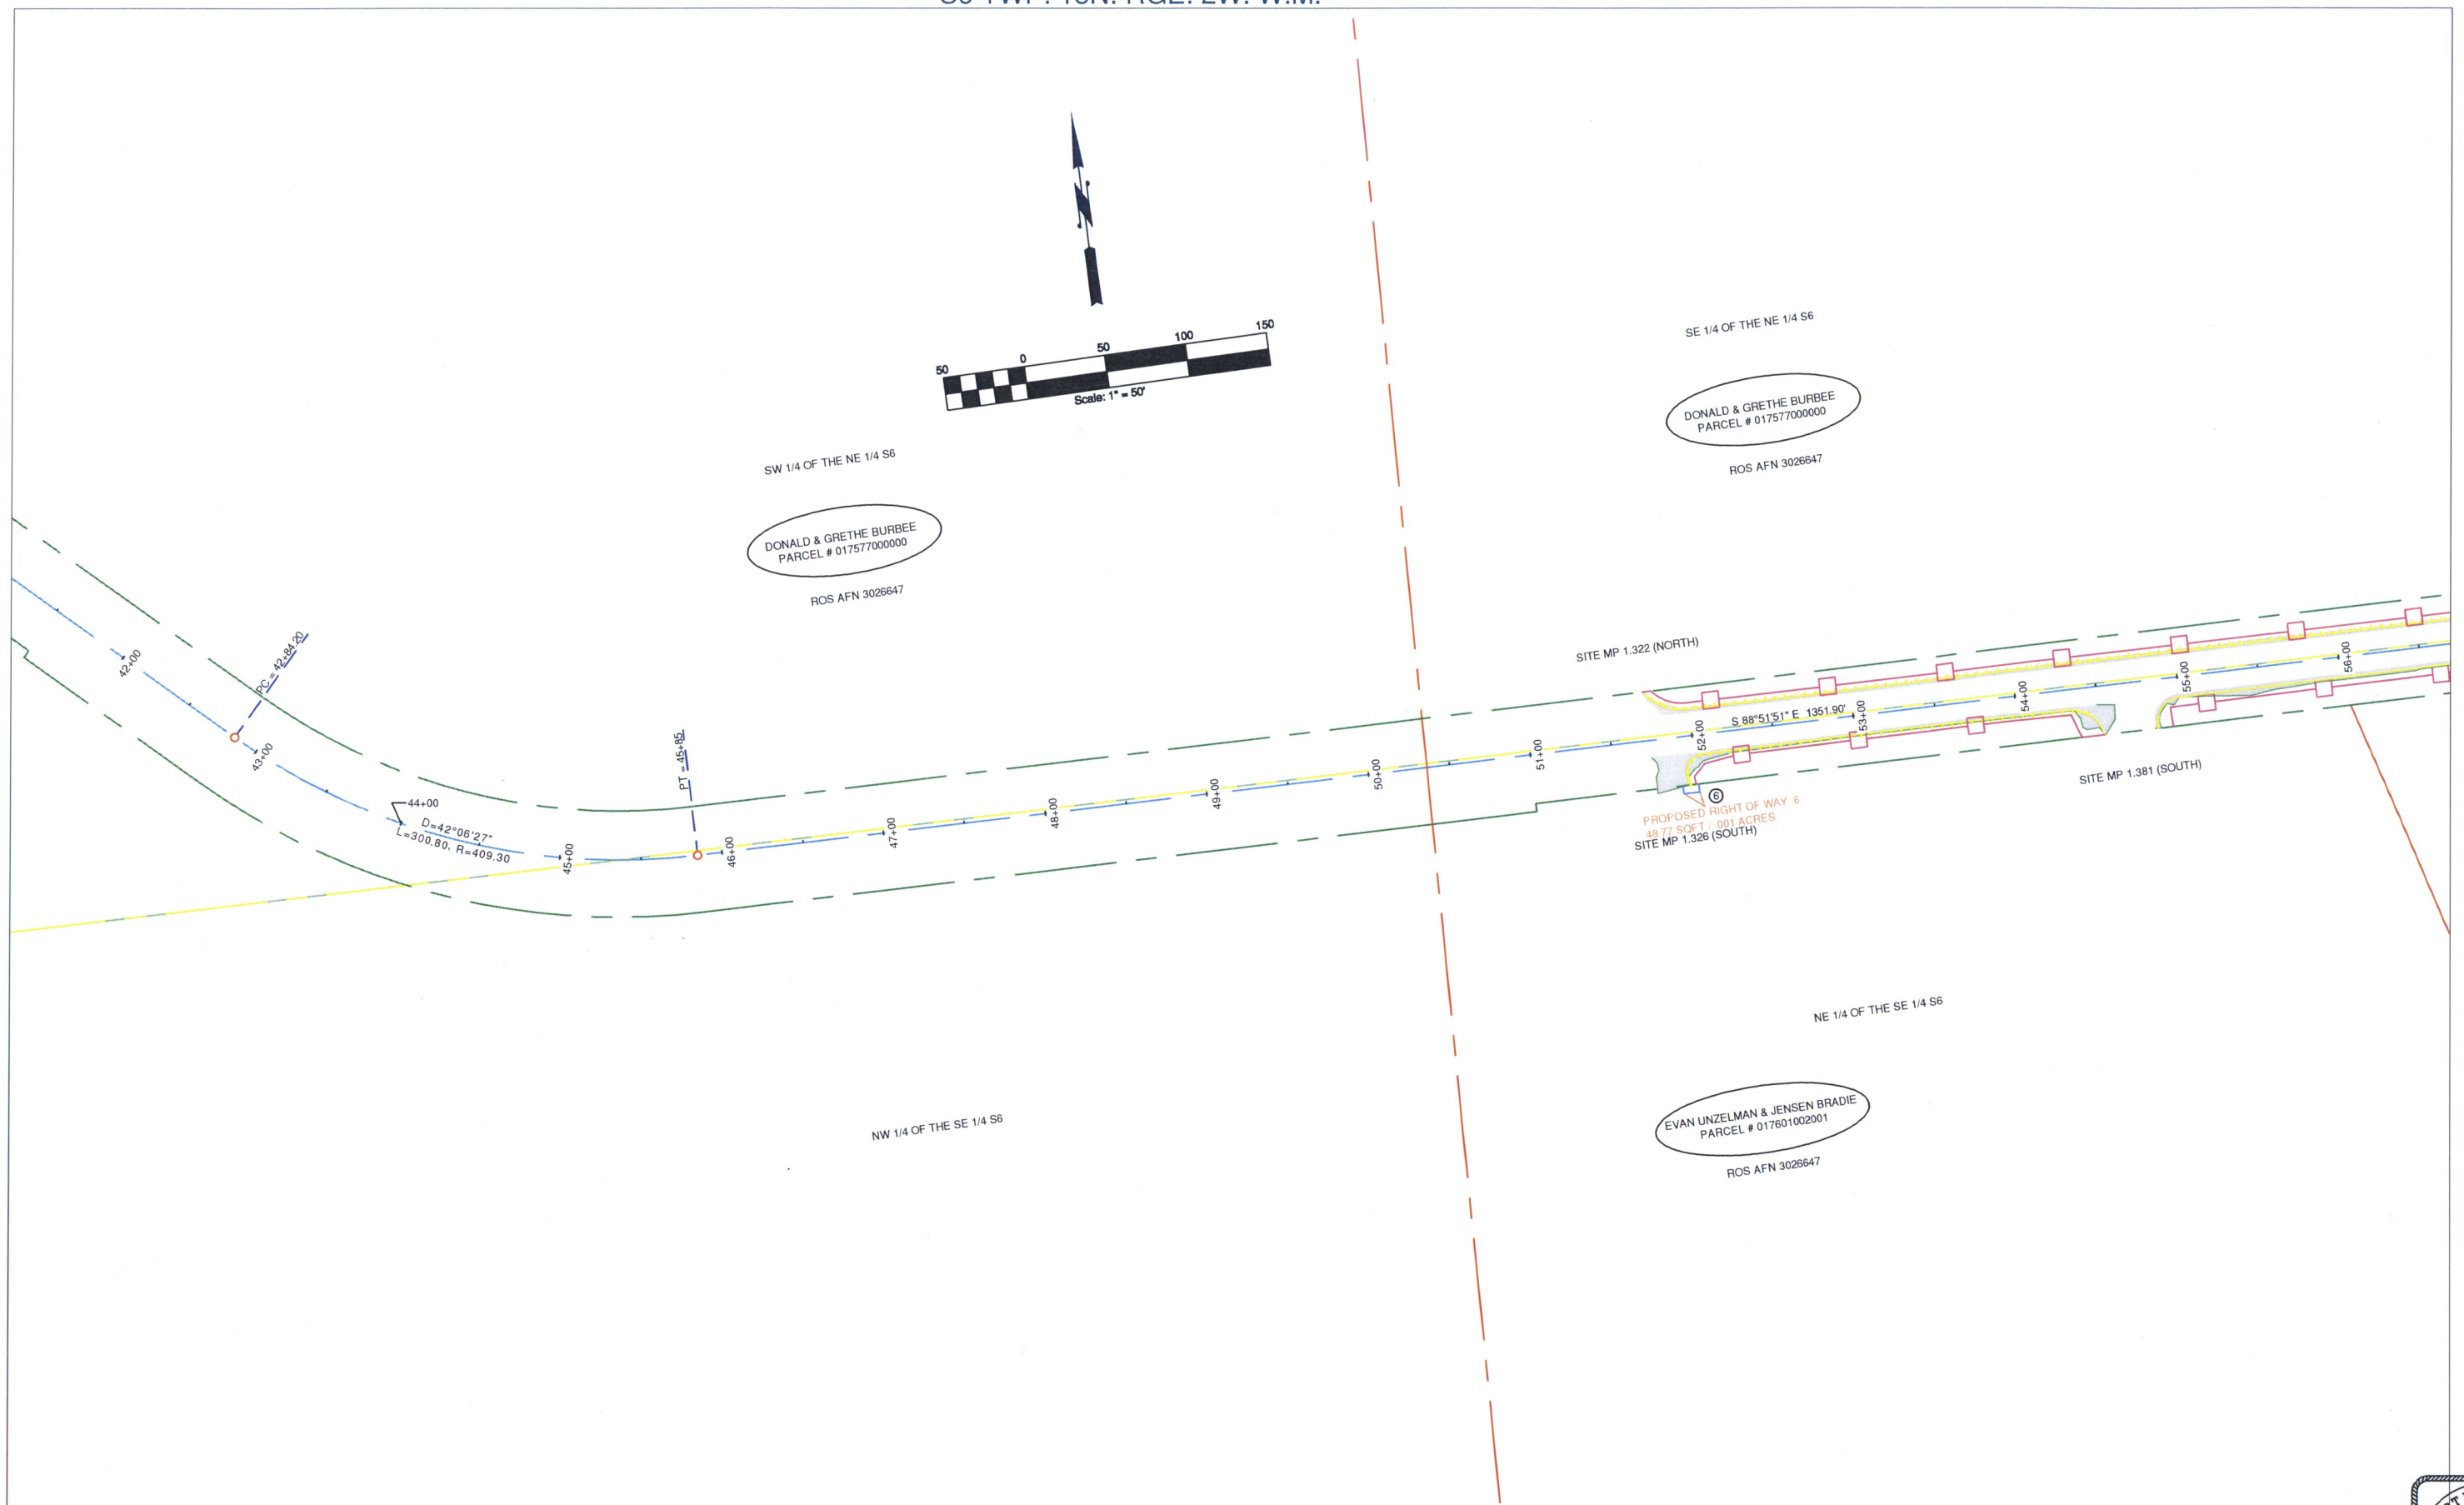

Lewis County
Department of Public Works

2025 NE KRESKY AVE.
CHEHALIS WA 98532
PHONE # (360) 740-1123
FAX # (360) 740-2719

DESIGNED BY :
DRAWN BY : TS
CHECKED BY :
DATE : 6-30-16

RIGHT OF WAY ALIGNMENT APPROVED BY :

SURVEY :	DATE :
PROPERTY MANAGEMENT :	DATE :
ASSISTANT COUNTY ENGINEER:	DATE :

NO.	DATE	REVISION	BY	APP.

SHOREY RD.
LEWIS COUNTY SAFETY
PROGRAM PHASE 2

COUNTY ROAD PROJECT NO: 2174B
RAP PROJECT NO: ???????
FEDERAL-AID NO: ????????

RIGHT OF WAY MAP
STA 42+00 TO STA 71+00

SHEET 6 OF 10

CALL 48 HOURS BEFORE YOU DIG
1-800-424-5555
"It's the Law"
Utilities Underground Location Center

Martin P. Roy, P.L.S.
Senior Engineer
Land Development Liaison

Date: _____

MARTIN P. ROY
STATE OF WASHINGTON
39081
REGISTERED
PROFESSIONAL LAND SURVEYOR

S5 & S6 TWP. 13N. RGE. 2W. W.M.

LAND LINES ARE APPROXIMATE

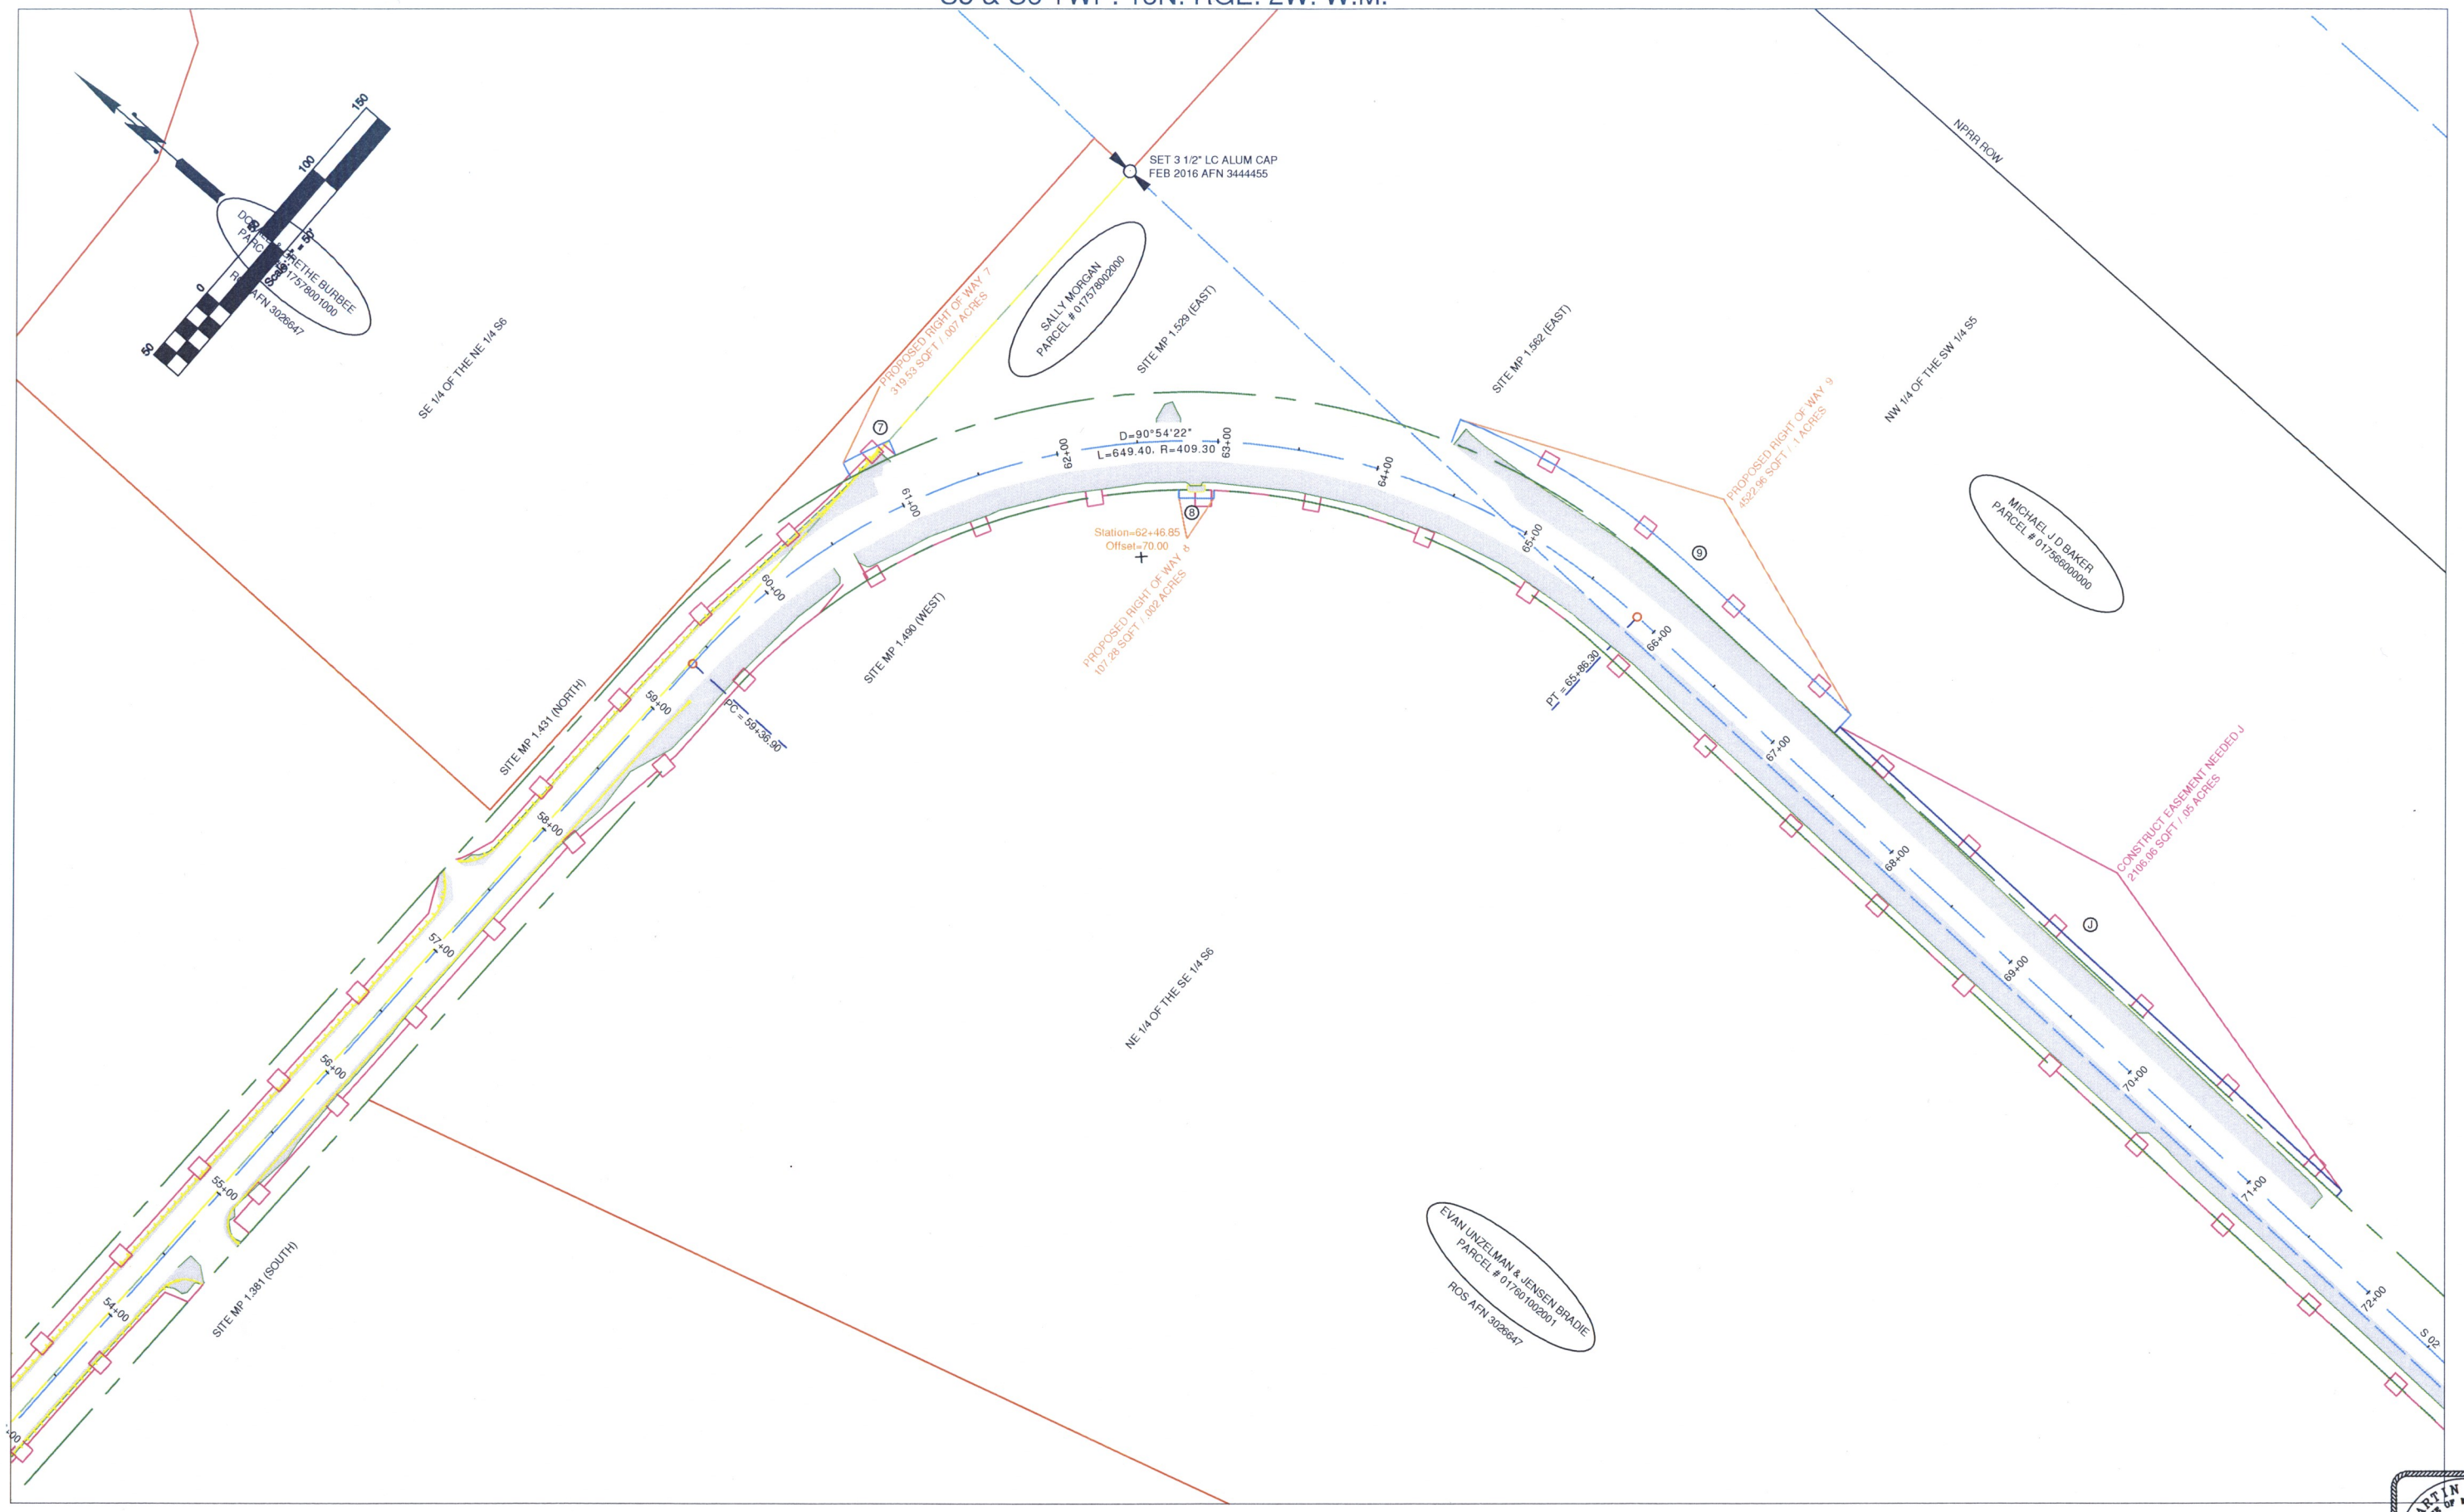

Lewis County Department of Public Works	2025 NE KRESKY AVE. CHEHALIS WA 98532 PHONE # (360) 740-1123 FAX # (360) 740-2719	DESIGNED BY : DRAWN BY : TS CHECKED BY : DATE : 6-30-16	RIGHT OF WAY ALIGNMENT APPROVED BY : SURVEY : DATE : PROPERTY MANAGEMENT : DATE : ASSISTANT COUNTY ENGINEER: DATE :	NO.	DATE	REVISION	BY	APP.	SHOREY RD. LEWIS COUNTY SAFETY PROGRAM PHASE 2

COUNTY ROAD PROJECT NO: 2174B RAP PROJECT NO: ???????? FEDERAL-AID NO: ???????? RIGHT OF WAY MAP STA 55+00 TO STA 71+00	SHEET 7 OF 10	CALL 48 HOURS BEFORE YOU DIG 1-800-424-5555 "It's the Law" Utilities Underground Location Center	Martin P. Roy, P.L.S. Senior Engineer Land Development Liaison Date:	MARTIN P. ROY STATE OF WASHINGTON 25001 REGISTERED PROFESSIONAL LAND SURVEYOR

S5 & S6 TWP. 13N. RGE. 2W. W.M.

LAND LINES ARE APPROXIMATE

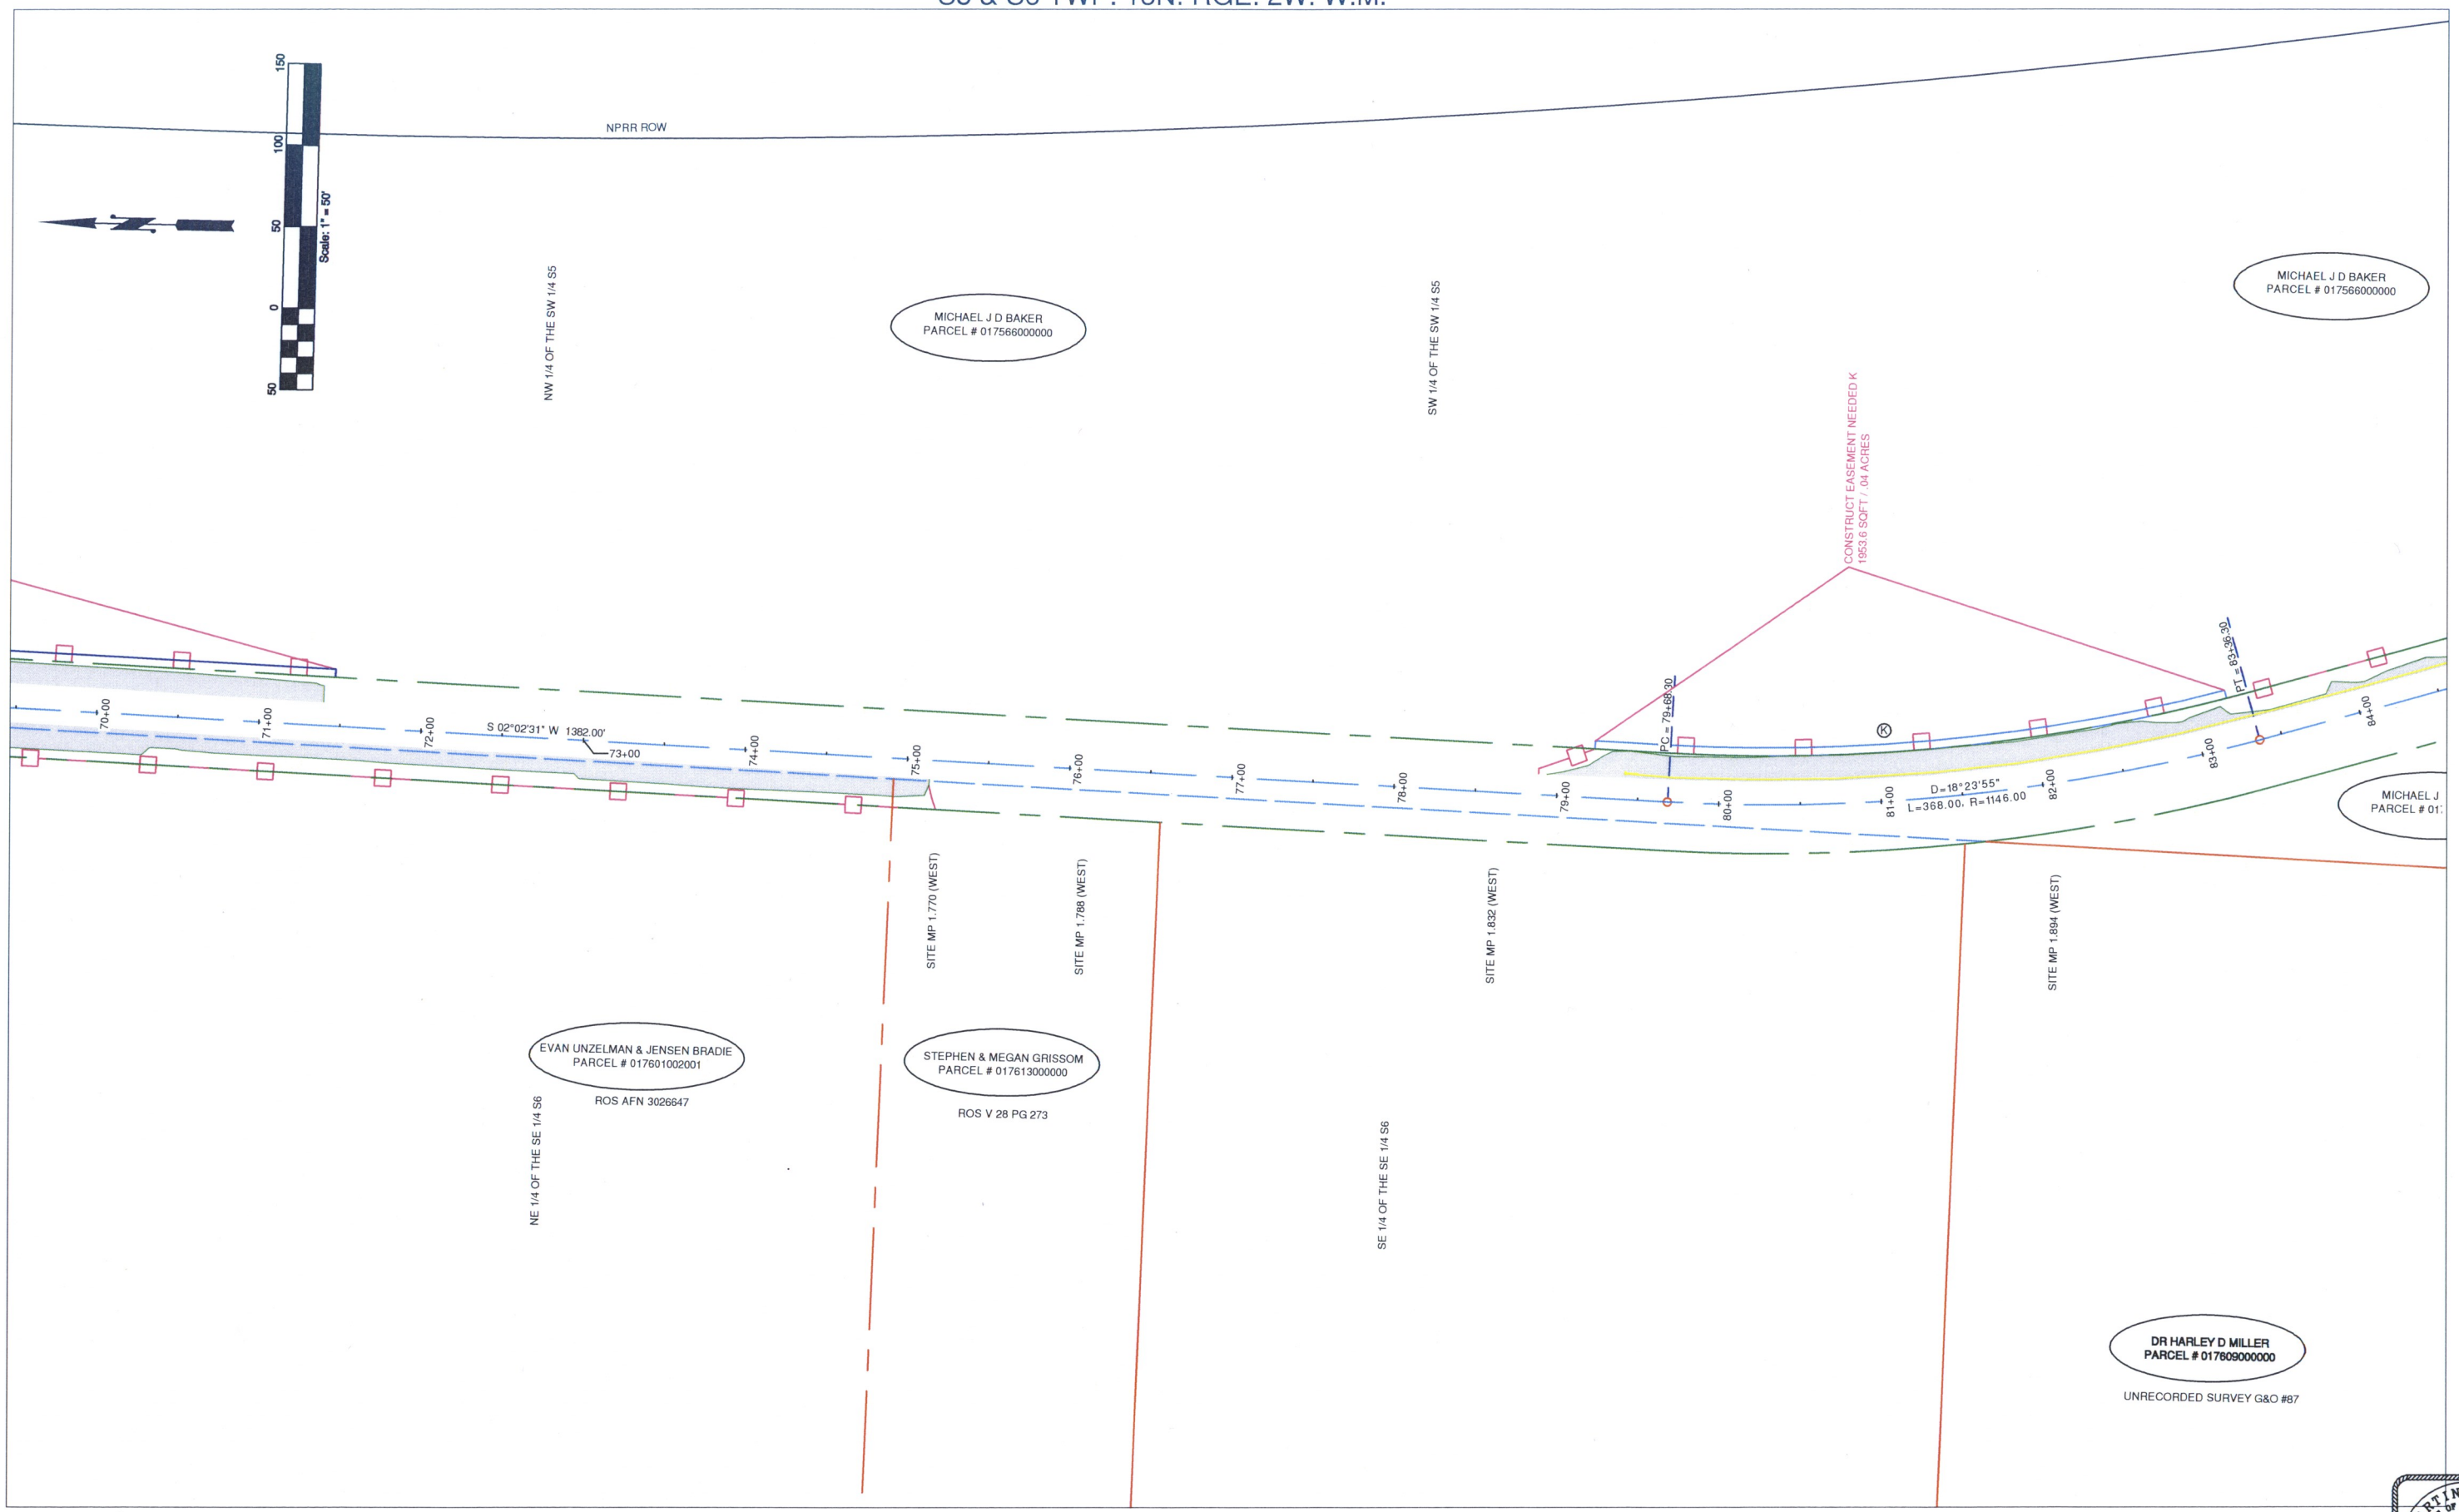

Lewis County Department of Public Works 2025 NE KRESKY AVE. CHEHALIS WA 98532 PHONE # (360) 740-1123 FAX # (360) 740-2719	DESIGNED BY : DRAWN BY : TS CHECKED BY : DATE : 6-30-16	RIGHT OF WAY ALIGNMENT APPROVED BY : SURVEY : DATE : PROPERTY MANAGEMENT : DATE : ASSISTANT COUNTY ENGINEER: DATE :	NO.	DATE	REVISION	BY	APP.	SHOREY RD. LEWIS COUNTY SAFETY PROGRAM PHASE 2

COUNTY ROAD PROJECT NO: 2174B RAP PROJECT NO: ??????? FEDERAL-AID NO: ???????? RIGHT OF WAY MAP STA 71+00 TO STA 84+00	SHEET 8 OF 10	CALL 48 HOURS BEFORE YOU DIG 1-800-424-5555 "It's the Law" Utilities Underground Location Center	Martin P. Roy, P.L.S. Senior Engineer Land Development Liaison Date: _____

MARTIN P. ROY
STATE OF WASHINGTON
25061
REGISTERED
PROFESSIONAL LAND SURVEYOR

S5 & S8 TWP. 13N. RGE. 2W. W.M.

LAND LINES ARE APPROXIMATE

NPRR (PER PLAN AND BLAM BK1 PG 170 FOR DEPICTION ONLY)

Scale: 1" = 50'

MICHAEL J D BAKER
PARCEL # 017566000000

UNVACATED 30' STRIP

RAY JOHNSTON
PARCEL # 017670000000
DEED AFN 3395049

PROPOSED RIGHT OF WAY 10
1266.81 SQFT / .03 ACRES

RAY JOHNSTON
PARCEL # 017669004000
DEED AFN 3395049

84+00 85+00 86+00 87+00 88+00 89+00 90+00 91+00 92+00 93+00 94+00 95+00 96+00 97+00 98+00

88+41.42

S 16°21'24" E 2215.50'

MICHAEL J D BAKER
PARCEL # 017566000000

T13N R2W E-05
CALCULATED PER ROBERTS
RD PROJECT

ROS V 25 PG 279

DONAL P HOLLIS
PARCEL # 017816001001
ROS V 4 PG 160

Lewis County Department of Public Works	2025 NE KRESKY AVE. CHEHALIS WA 98532 PHONE # (360) 740-1123 FAX # (360) 740-2719	DESIGNED BY : DRAWN BY : TS CHECKED BY : DATE : 6-30-16	RIGHT OF WAY ALIGNMENT APPROVED BY : SURVEY : DATE : PROPERTY MANAGEMENT : DATE : ASSISTANT COUNTY ENGINEER: DATE :	NO.	DATE	REVISION	BY	APP.

SHOREY RD.
LEWIS COUNTY SAFETY
PROGRAM PHASE 2

COUNTY ROAD PROJECT NO: 2174B
RAP PROJECT NO: ???????
FEDERAL-AID NO: ????????

RIGHT OF WAY MAP
STA 84+00 TO STA 98+00

SHEET 9 OF 10

CALL 48 HOURS BEFORE YOU DIG
1-800-424-5555
"It's the Law"
Utilities Underground Location Center

Martin P. Roy, P.L.S.
Senior Engineer
Land Development Liaison

Date: _____

MARTIN P. ROY
STATE OF WASHINGTON
35061
REGISTERED
PROFESSIONAL LAND SURVEYOR

S8 TWP. 13N. RGE. 2W. W.M.

LAND LINES ARE APPROXIMATE

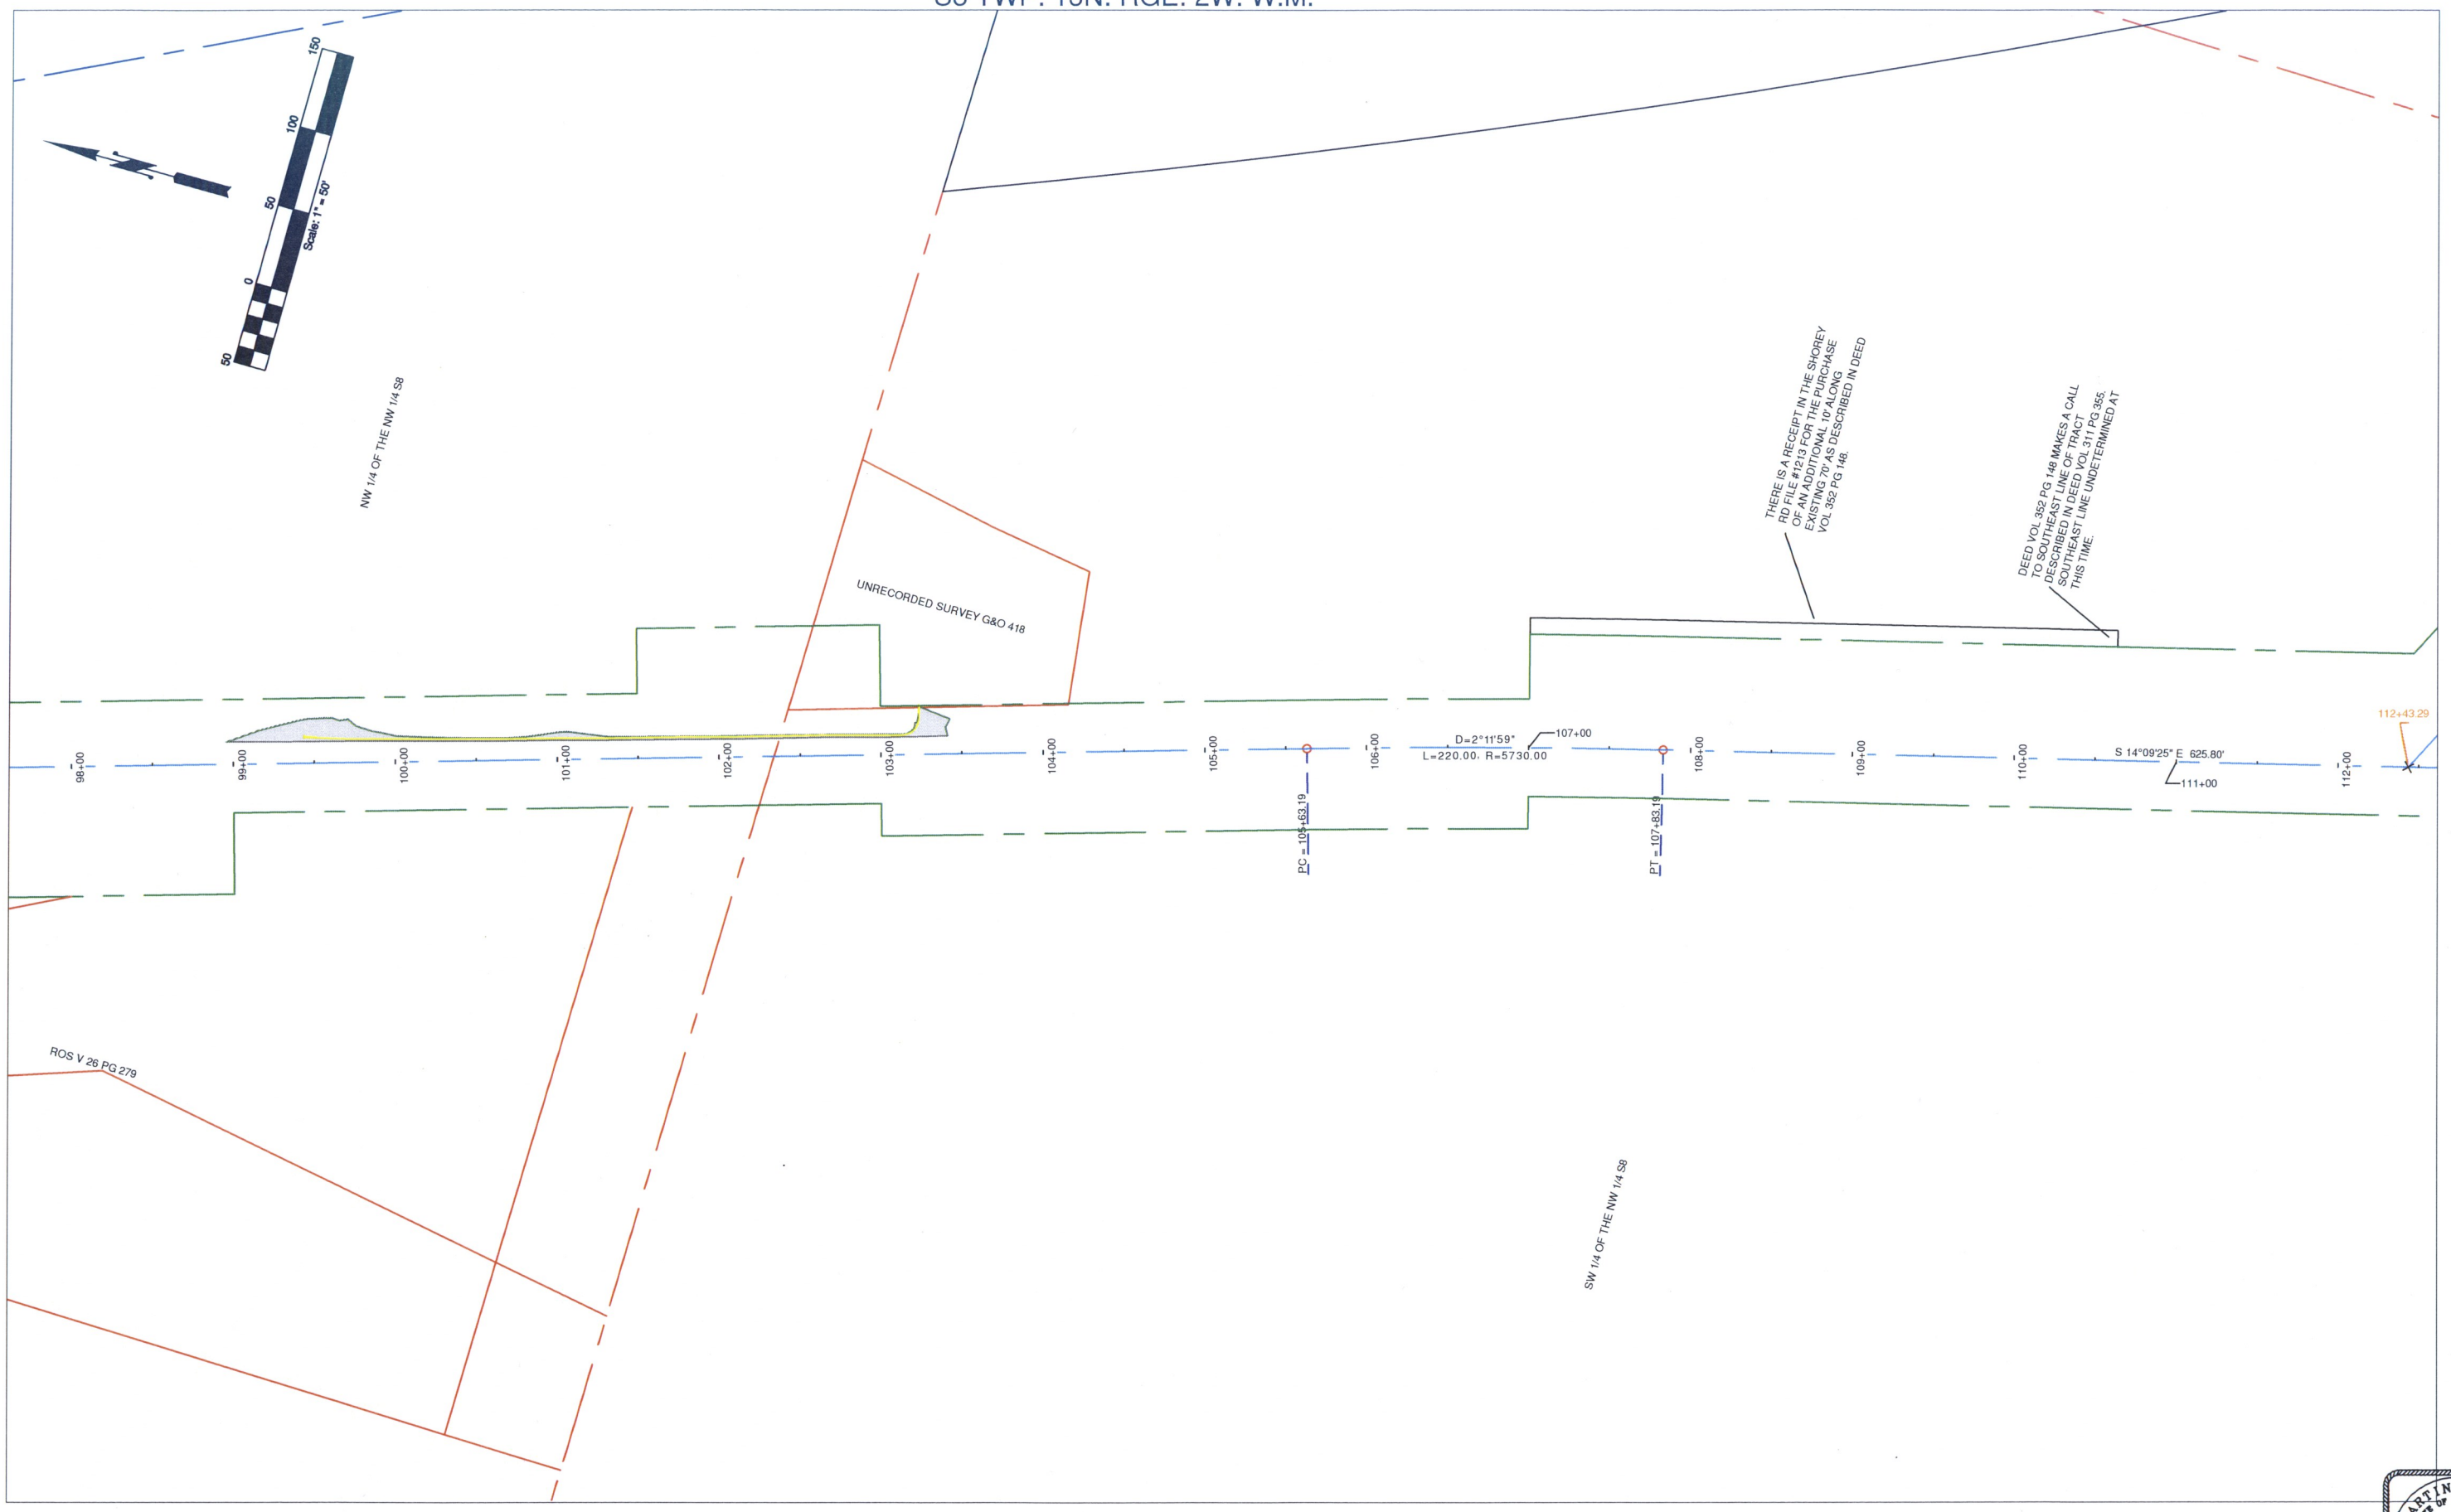

Lewis County Department of Public Works	2025 NE KRESKY AVE. CHEHALIS WA 98532 PHONE # (360) 740-1123 FAX # (360) 740-2719	DESIGNED BY : DRAWN BY : TS CHECKED BY : DATE : 6-30-16	RIGHT OF WAY ALIGNMENT APPROVED BY : SURVEY : DATE : PROPERTY MANAGEMENT : DATE : ASSISTANT COUNTY ENGINEER: DATE :	NO. / DATE / REVISION / BY / APP.		SHOREY RD. LEWIS COUNTY SAFETY PROGRAM PHASE 2	COUNTY ROAD PROJECT NO: 2174B RAP PROJECT NO: ??????? FEDERAL-AID NO: ???????? RIGHT OF WAY MAP STA 98+00 TO STA 112+00	SHEET 10 OF 10	CALL 48 HOURS BEFORE YOU DIG 1-800-424-5555 "It's the Law" Utilities Underground Location Center	Martin P. Roy, P.L.S. Senior Engineer Land Development Liaison Date: _____

MARTIN P. ROY — STATE OF WASHINGTON — 35081 — REGISTERED PROFESSIONAL LAND SURVEYOR